
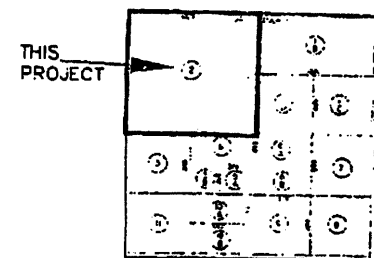


** Sign Location*

LOT-F is for the entire 40.155 acres

DAVIS RANCH ROAD

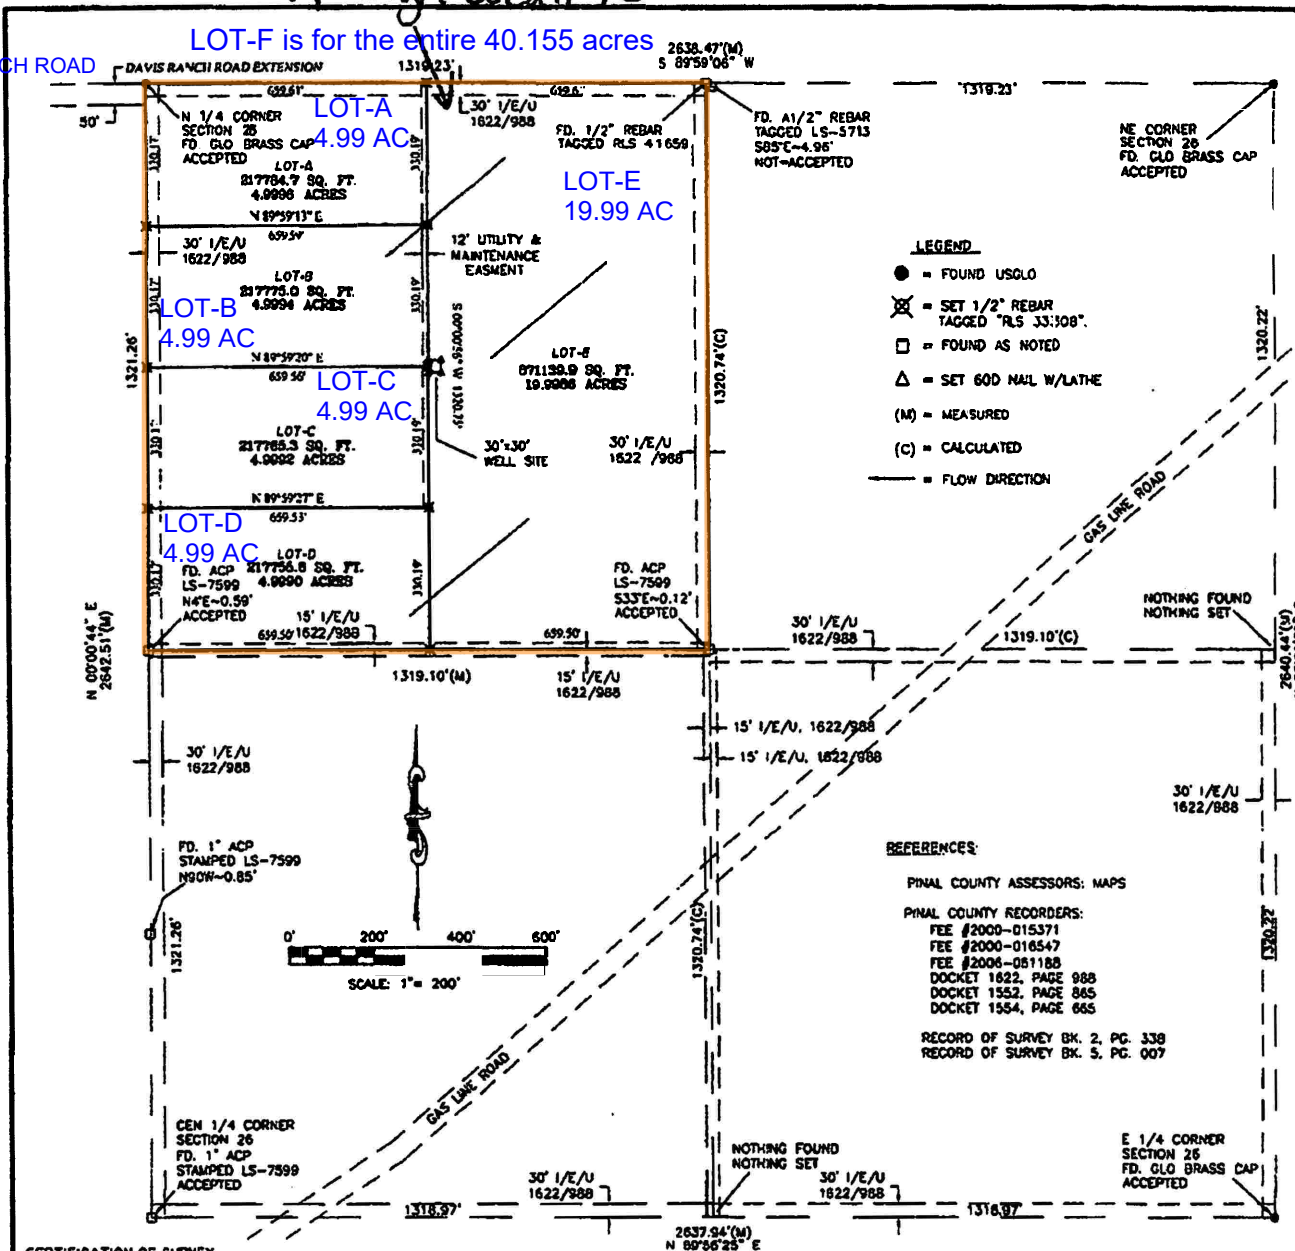

LOCATION MAP
NE 1/4, SECTION 26, T10S, R 11 E
SCALE: 3" = 1/2 MILE

LEGEND

- = FOUND USGLO
- ✕ = SET 1/2" REBAR TAGGED "RLS 33:108"
- = FOUND AS NOTED
- △ = SET 60D NAIL W/LATHE
- (M) = MEASURED
- (C) = CALCULATED
- = FLOW DIRECTION

REFERENCES:

PINAL COUNTY ASSESSORS: MAPS
PINAL COUNTY RECORDERS:
FEE #2000-016371
FEE #2000-016547
FEE #2008-081188
DOCKET 1822, PAGE 988
DOCKET 1552, PAGE 845
DOCKET 1554, PAGE 665
RECORD OF SURVEY BK. 2, PG. 338
RECORD OF SURVEY BK. 3, PG. 007

STATE OF ARIZONA }
COUNTY OF PINAL } ss

I hereby certify that the within instrument is filed in the official records of this County in Survey Book _____ Page _____

Date: _____

Request of: _____

Witness my hand and official seal
L. AURA DEAN-LYTLIE, Pinal County Recorder
By: _____ Deputy

NOTES:

- 1- THIS SURVEY WAS PERFORMED WITHOUT A TITLE REPORT. NO ATTEMPT HAS BEEN MADE TO LOCATE POSSIBLE EASEMENTS, EXCEPT AS SHOWN.
- 2- BASIS OF BEARINGS- *ASTRONOMIC*- DERIVED FROM GLOBAL POSITIONING OBSERVATIONS. ALL LINE BEARINGS SHOWN HEREON STAND ALONE AS A TRUE SURFACE BEARING.
- 3- PROPERTY IS FENCED ON THE EASTSIDE ONLY.
- 4- PROPERTY OWNER: TORTOLITA RANCH, LLC.
- 5- ZONING: "GR" - GENERAL RURAL.
- 6- FLOOD ZONE: "C", FEMA MAP D400771450C.
- 7- APN: 410-32-0020.

PINAL COUNTY
MLD# 07- XXXX

CERTIFICATION OF SURVEY

THIS IS TO CERTIFY THAT THIS SURVEY WAS PERFORMED UNDER MY DIRECTION DURING THE MONTH OF NOVEMBER, 2007 AND THAT ALL MONUMENTS EXIST AS SHOWN.

ROBERT P. ACKEN
REGISTERED LAND SURVEYOR
ARIZONA REGISTRATION No. 41659

Record Survey Consultants
Phone (520)625-2011
Mobile (520)331-0088
LARS Surveys

RECORD OF SURVEY
FOR
TORTOLITA RANCH, LLC.
THE NW 1/4 OF THE NE 1/4
OF SECTION 26, T10S, R11E,
G. & S.R.M.
PINAL COUNTY, ARIZONA.

DATE: 12/02/07 JOB # 27140