

FIRST VISIT   
 SUBSEQUENT VISIT   
 UNKNOWN

INSTALLATION OR REPAIR RECORD OF SEPTIC TANK SYSTEM

7/1-65

Residence

TYPE OF ESTABLISHMENT

OWNER Russell Church ADDRESS \_\_\_\_\_

LOCATION RT # 1 Columbia \_\_\_\_\_

CIVIL DISTRICT 8


OCCUPANT \_\_\_\_\_ ADDRESS \_\_\_\_\_

TANK: TYPE Precast concrete LIQUID CAPACITY (GALS.) 750

FIELD LINE: LINEAR FEET OF TILE 100' WIDTH OF TRENCH 36" LENGTH OF TRENCH 100'

DEPTH OF TRENCH 24"-48" DEPTH OF STONE 12" GARBAGE GRINDER PROPOSED: YES ( ) NO ( )

SKETCH OF SYSTEM: BY \_\_\_\_\_ DATE \_\_\_\_\_ INSTALLED BY Ross McGee

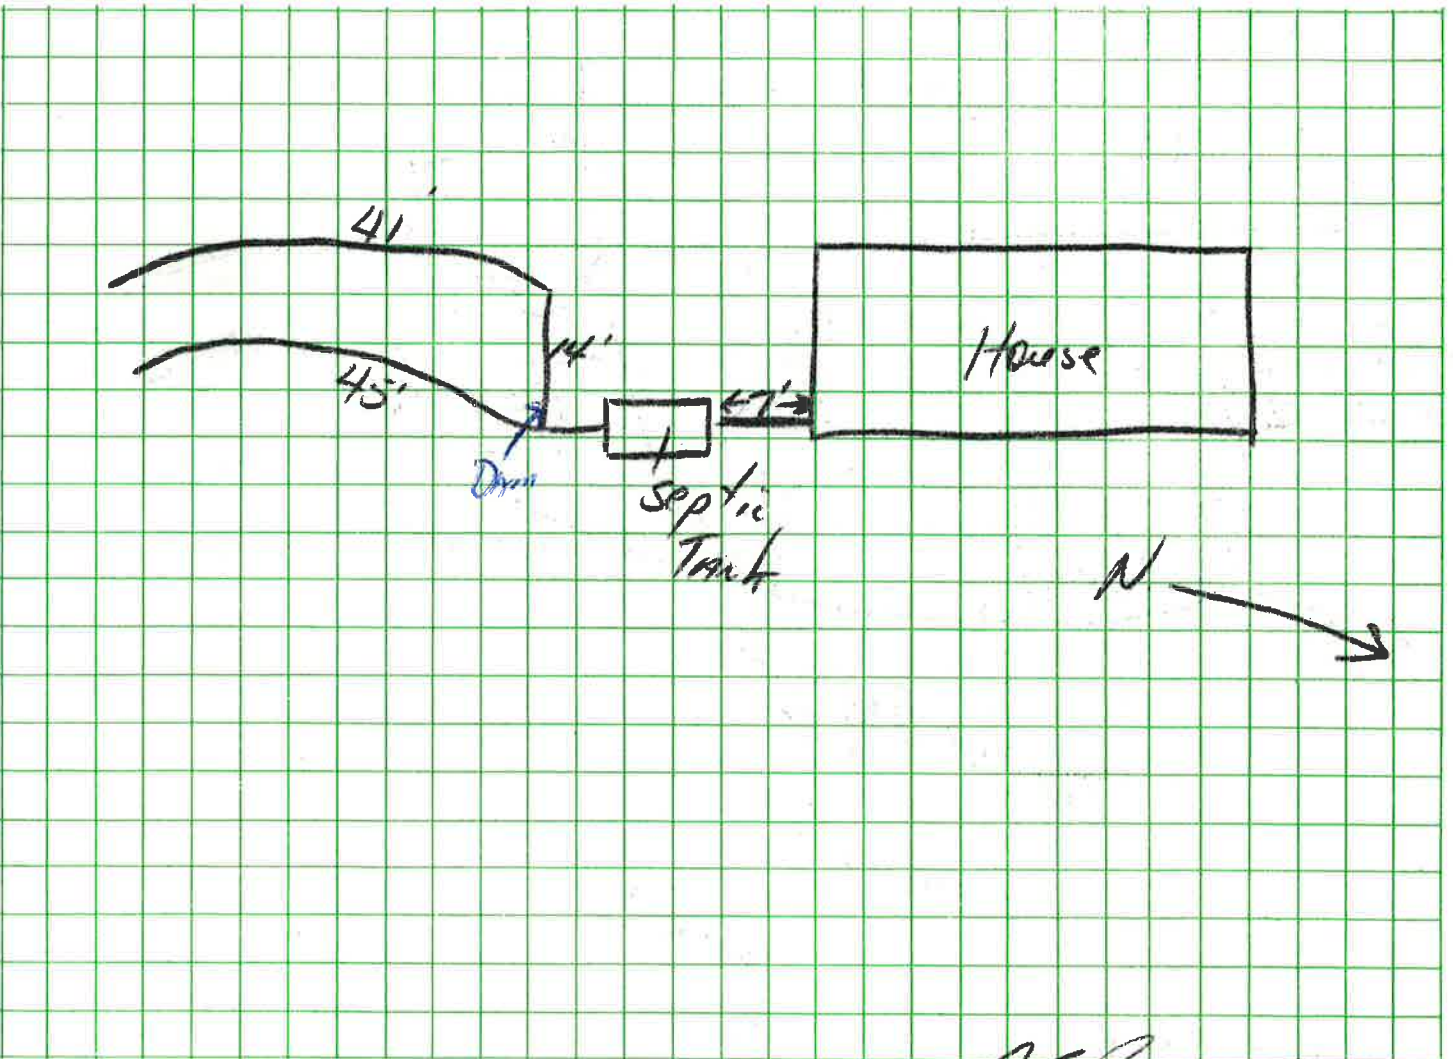

FINAL APPROVAL: YES (X) NO ( ) DATE 7-1-65 \_\_\_\_\_ SIGNATURE [Signature]

REMARKS: Septic tank not higher level than well.

NOTE: Plumber must notify the \_\_\_\_\_ Health Department (Phone \_\_\_\_\_) when the septic tank system is ready for inspection. If any septic tank system or part thereof is covered before being regularly inspected and approved, it shall be uncovered by the plumber at the direction of the Health Officer or his authorized representative.