

INSPECTION REPORT FOR
PRIVATE SEWAGE SYSTEMS

☒ CONVENTIONAL ☐ ALTERNATIVE
☐ Holding Tank ☐ In-Ground Pressure ☐ Mound

State Plan 1 D. Not Used
(If assigned)

NAME OF PERMIT HOLDER: ROBERT TURNWALL	ADDRESS OF PERMIT HOLDER: RT. 1 LAFARCA, WI 54639	INSPECTION DATE: 10-15-88
BENCH MARK (Permanent reference point) DESCRIBE IF DIFFERENT FROM PLAN: -		REF. PT. ELEV.: -
NAME OF PLUMBER: STACY DORRIS	AMPSW No.: 2708	County: VERNON
Sanitary Permit Number: 95735		54-88

SEPTIC TANK/HOLDING TANK:

MANUF. ACTUATOR: CREST	LIQUID CAPACITY: 750	TANK INLET ELEV.: NOT INSTALLED	TANK OUTLET ELEV.: NOT INSTALLED	WARNING LABEL PROVIDED: ☒ YES ☐ NO	LOCKING COVER PROVIDED: ☐ YES ☒ NO
BODDING: ☐ YES ☒ NO	VENT DIA: -	VENT MATL: -	HIGH WATER ALARM: ☐ YES ☒ NO	NUMBER OF FEET FROM NEAREST ROAD: > 60'	PROPERTY LINE: > 75'
			WELL: > 75'	BUILDING: > 25'	VENT TO FRESH AIR INLET: -

DOSING CHAMBER:

MANUF. ACTUATOR: ☐ YES ☒ NO	LIQUID CAPACITY:	PUMP MODEL:	PUMP/SIGNAL MANUF. ACTUATOR:	WARNING LABEL PROVIDED: ☐ YES ☒ NO	LOCKING COVER PROVIDED: ☐ YES ☒ NO
GALLONS PER CYCLE: (DIFFERENCE BETWEEN PUMP ON AND OFF)		PUMP AND CONTROLS OPERATIONAL: ☐ YES ☒ NO		NUMBER OF FEET FROM NEAREST ROAD: > 60'	PROPERTY LINE: > 75'
SOIL ABSORPTION SYSTEM. Check the soil moisture at the depth of plowing or excavation. (If soil can be rolled into a wire, construction shall cease until the soil is dry enough to continue.)			FORCE MAIN: LENGTH: DIAMETER: MATERIAL AND MARKING:		

CONVENTIONAL SYSTEM:

BED/TRENCH DIMENSIONS: 10' x 80'	WIDTH: 10'	LENGTH: 80'	NO. OF TRENCHES: -	DISTR. PIPE SPACING: -	COVER MATERIAL: TYPIC	INSIDE DIA: PIT	WELLS: -	LIQUID DEPTH: -
GRAVEL DEPTH BELOW PIPES: OK	PIPE DEPTH ABOVE COVER: -	DISTR. PIPE ELEV. INLET: -	DISTR. PIPE ELEV. END: -	DISTR. PIPE MATERIAL: 2-229	NO. DISTR. PIPES: 2	NUMBER OF FEET FROM NEAREST ROAD: > 75'	PROPERTY LINE: > 150'	BUILDING: > 150'
						WELL: > 150'	VENT TO FRESH AIR INLET: > 150'	

MOUND SYSTEM:

Mound site plowed perpendicular to slope and furrows thrown upslope: ☐ YES ☒ NO	Check the texture of the fill material for mound systems to make certain that it meets the criteria for medium sand.	PROVIDE A DIAGRAM OF SYSTEM ON REVERSE SIDE. SHOW ELEVATIONS MEASURED.
SOIL COVER: TEXTURE	PERMANENT MARKERS: ☐ YES ☒ NO	OBSERVATION WELLS: ☐ YES ☒ NO
DEPTH COVER OVER NEAREST CENTER	DEPTH COVER OVER TRENCH BED LOGS	DEPTH OF TOPSOIL
SEEDING: ☐ YES ☒ NO	SEEDING: ☐ YES ☒ NO	MULCHED: ☐ YES ☒ NO


PRESSURIZED DISTRIBUTION SYSTEM:

BED/TRENCH DIMENSIONS:	WIDTH:	LENGTH:	NO. OF TRENCHES:	LATERAL SPACING:	GRAVEL DEPTH BELOW PIPE:	FILL DEPTH ABOVE COVER:
ELEVATION AND DISTRIBUTION INFORMATION:	MANIFOLD ELEV.	PUMP ELEV.	MANIFOLD DIA.	DISTR. PIPE ELEV.	MANIFOLD MATERIAL:	NO. DISTR. PIPES:
	HOLE SIZE:	HOLE SPACING:	DRILLED CORRECTLY: ☐ YES ☒ NO	COVER MATERIAL:	DISTRIBUTION PIPE MATERIAL & MARKING:	
COMMENTS:			PERMANENT MARKERS: ☐ YES ☒ NO	OBSERVATION WELLS: ☐ YES ☒ NO	NUMBER OF FEET FROM NEAREST ROAD: > 75'	PROPERTY LINE: > 150'
					WELL: > 150'	BUILDING: > 150'

Sketch System on
Reverse Side.

Retain in county file for audit.

SIGNATURE: Frank M. [Signature]	TITLE: County Sanitarian
---	------------------------------------

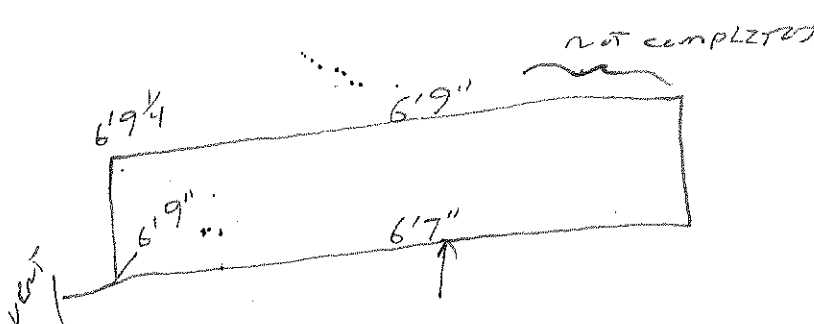

Tank and a portion
of the field was
not ready for
inspection.



SANITARY PERMIT APPLICATION

In accord with ILHR 83.05, Wis. Adm. Code

COUNTY
VERNO
STATE SANITARY PERMIT #
95735 54-88
STATE PLAN I.D. NUMBER
PETITION FOR VARIANCE ☐ YES ☒ NO

-Attach complete plans (to the county copy only) for the system, on paper not less than 8½ x 11 inches in size.

-See reverse side for instructions for completing this application.

I. APPLICANT INFORMATION - PLEASE PRINT ALL INFORMATION.

PROPERTY OWNER Robert TURNWALL			PROPERTY LOCATION SW ¼ SE ¼, S 15 T 13, N, R 2 E (or) W		
PROPERTY OWNER'S MAILING ADDRESS RT 1 LAFAARGE			LOT NUMBER	BLOCK NUMBER	SUBDIVISION NAME
CITY, STATE WISC	ZIP CODE 54639	PHONE NUMBER ()	☐ CITY ☐ VILLAGE ☒ TOWN OF: STARK		NEAREST ROAD, LAKE OR LANDMARK Maple Ridge

II. TYPE OF BUILDING OR USE SERVED:

Number of Bedrooms if 1 or 2 Family 2 OR ☐ Public (Specify):

III. PURPOSE OF APPLICATION: (Check only one in #1. Check # 2, 3 or 4, if applicable)

1. a. ☒ New System b. ☐ Replacement System c. ☐ Replacement of Septic Tank Only d. ☐ Reconnection of an Existing System e. ☐ Repair of an Existing System
2. ☐ A Sanitary Permit was previously issued. Permit # _____ Date Issued _____
3. ☐ An Existing System has been inspected and soil conditions meet minimum requirements.
4. ☐ The System is shared by more than one owner/building. Attach Common Ownership Agreement to County Copy.

IV. TYPE OF SYSTEM: (Check only one in #1 and only one in #2)

1. a. ☒ Conventional b. ☐ Alternative c. ☐ Experimental
2. a. ☐ System-In-Fill b. ☐ Holding Tank c. ☐ Pit Privy d. ☐ Vault Privy e. ☐ Mound f. ☐ IGP

V. ABSORPTION SYSTEM INFORMATION: (Check one)

1. a. ☒ Seepage Bed SEE PLAN DRAWING b. ☒ Seepage Trench c. ☐ Seepage Pit

2. PERCOLATION RATE (Minutes per inch): 24	3. ABSORPTION AREA REQUIRED (Square Feet): 120500	4. ABSORPTION AREA PROPOSED (Square Feet): 800 SQ. FT.	5. SYSTEM ELEVATION 97' Feet	6. WATER SUPPLY: ☒ Private ☐ Joint ☐ Public
---	--	---	---------------------------------	--

VI. TANK INFORMATION	CAPACITY in gallons		Total Gallons	# of Tanks	Manufacturer's Name	Prefab. Concrete	Site Constructed	Steel	Fiber-glass	Plastic	Exper. App.
	New Tanks	Existing Tanks									
Septic Tank or Holding Tank	750		750	1	CHEST PHE	☒	☐	☐	☐	☐	☐
Lift Pump Tank/Siphon Chamber					CHEST	☐	☐	☐	☐	☐	☐

VII. RESPONSIBILITY STATEMENT

I, the undersigned, assume responsibility for installation of the private sewage system shown on the attached plans.

Plumber's Name (Print): STACY DOBB	Plumber's Signature (No Stamps): Stacy Dobb	MP/MPBSW No.: 2708	Business Phone Number: (608) 337-4370
Plumber's Address (Street, City, State, Zip Code): Box 75 ONTARIO WISCONSIN 54651		Name of Designer: SAME	

VIII. SOIL TEST INFORMATION

Certified Soil Tester (CST) Name: Stacy Dobb	CST #: 2224
CST's ADDRESS (Street, City, State, Zip Code): Box 75 ONTARIO WISC. 54651	Phone Number: (608) 337-4370


IX. COUNTY/DEPARTMENT USE ONLY

☒ Approved	☐ Disapproved	Sanitary Permit Fee \$61	Groundwater Surcharge Fee 25	Date 10-14-88	Issuing Agent Signature (No Stamps) [Signature]
☐ Owner Given Initial		Adverse Determination			

X. COMMENTS/REASONS FOR DISAPPROVAL:

Robert TURNWALL
RT I LAFARGE

SW $\frac{1}{4}$ of SE $\frac{1}{4}$ S 15 T 13 N R 2 W

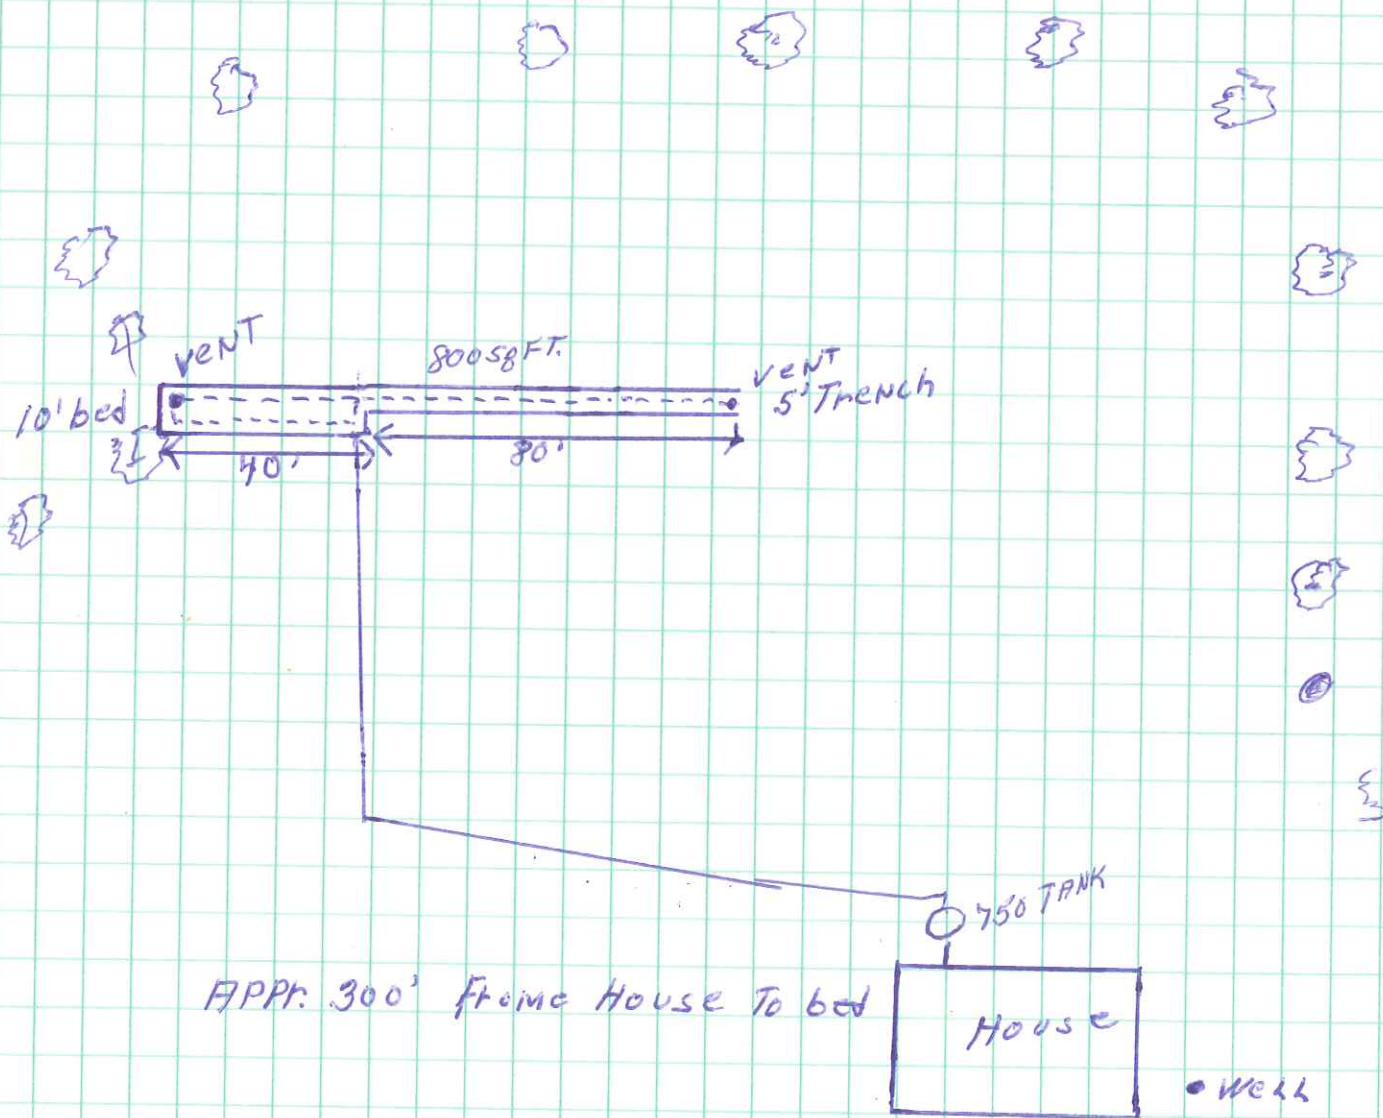

Stacy Doble
MPS 2708