


OP Number: 21-395

☒ New ☐ Expansion ☐ Repair

Tax Parcel #: 08259001A CA Number: 20-548 System Classification: IIIbg
Specific System Installed: Pump to Infiltrator Quick 4 Plus Low Profile Chambers IIIbg
Gallons Per Day: 360 Number of Bedrooms: 3 Occupancy: 6

Owner: Southern Interior Design Site location: 6905 West Duncan Rd
Address: 6812 W. Duncan Rd. Subdivision: —
Indian Trail, NC 28079 Lot #: —

This system has been installed in compliance with applicable NC General Statutes, Rules for Sewage Treatment and Disposal, and all conditions of the Improvement Permit and Construction Authorization.

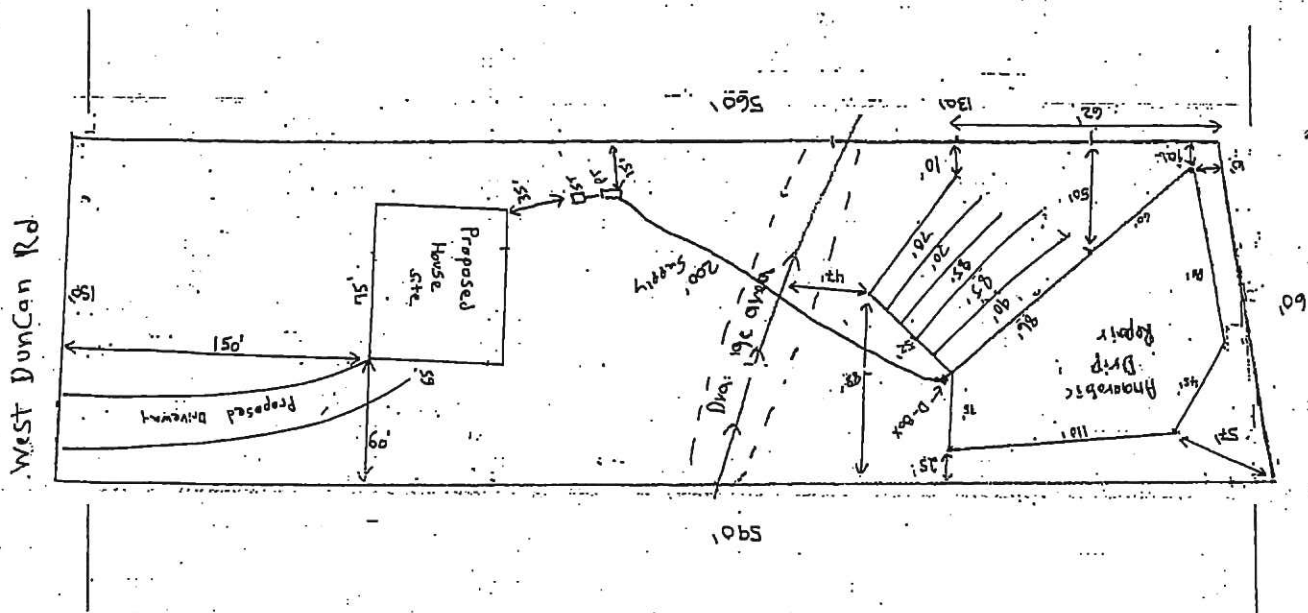

Certified System Installer: Jeremy Hildreth

Authorized State Agent:

Date: 10/18/2021

Operation Permit Conditions on back:

Permit Conditions:

15A NCAC 18A .1961 (a): Any person owning or controlling the property upon which a ground absorption sewage treatment and disposal system is installed shall be responsible for the following items regarding the maintenance of the system:

(1)(A), (B) Summarized: Ground absorption sewage treatment and disposal systems shall be operated and maintained to prevent; a discharge of sewage or effluent to the ground surface, surface waters, or into groundwater, or a back-up of sewage or effluent into the facility, drains, or collection system.

All Systems:

- Maintain ground cover over system to promote rain water to flow off of the system, and to prevent erosion, or small trees or brush from establishing over the system area.
- The contents of the septic tank shall be removed periodically from all compartments. The contents shall be pumped whenever the solids level is found to be more than 1/3 of the liquid depth in any compartment.
- Pump tanks shall be pumped when the solids level is 6".

†Type IV, Type V, Type VI require a Certified Subsurface System Operator per 15A NCAC .1961(b).

Subsurface system operator required? Yes _____ No _____

If yes, see attached sheet for additional operation conditions, maintenance and reporting.

Comments: _____



Certificate of Completion Private Well

COC #: COC262042 Well Permit #: 20-595 CA Permit #: _____

Proposed Use: ☒ Drinking Water Well ☐ Irrigation Well ☐ Well Abandonment ☐ Well Repair

Owner Information:

Name: Michael Snitko

Mailing Address: 6905 W Duncan Rd
Indian Trail, NC 28079-8884

Well Site Information:


Parcel #: 08258001A

Road Name: 6905 W Duncan Rd Indian Trail, NC

Subdivision: _____

Lot #: _____

Site Sketch

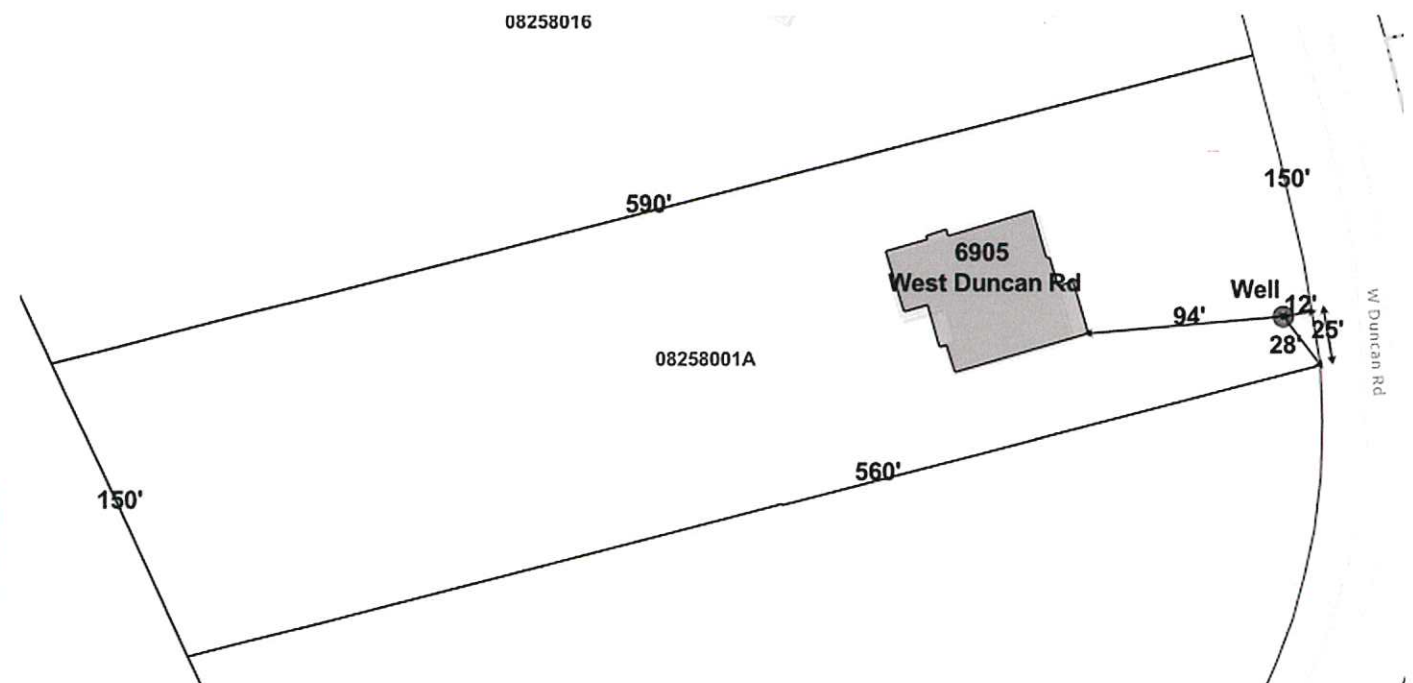

=This well was constructed, repaired, or abandoned in compliance with the well permit and in accordance with 15A NCAC 02C .0100 and .0300.

The well owner shall not place potential sources of groundwater contamination closer to the well than the separation distances specified in 15A NCAC 02C .0100.

Authorized Agent's Printed Name: Matthew Mercuri

Authorized Agent's Signature: _____

Date: 11/18/2021