

TEXAS COMMISSION ON ENVIRONMENTAL QUALITY

*Be it known that*

**TOM EMERY**

*has fulfilled the requirements in accordance with the  
laws of the State of Texas for*

**CLASS II OSSF INSTALLER**

*License Number:* OS0028768

*Issue Date:* 08/20/2009

*Expiration Date:* 08/31/2012



*Executive Director*

*Texas Commission on Environmental Quality*

TEXAS COMMISSION ON ENVIRONMENTAL QUALITY

*Be it known that*

**TOM EMERY**


*has fulfilled the requirements in accordance with the  
laws of the State of Texas for*

**OSSF SITE EVALUATOR**

*License Number:* OS0029481

*Issue Date:* 01/20/2011

*Expiration Date:* 01/31/2014

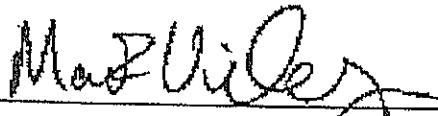

*Executive Director*

*Texas Commission on Environmental Quality*

Emery Dirt & Septic Service 895104  
502-NCR 2930 806-778-2349  
Lubbock, TX 79403

CUSTOMER'S ORDER NO.	DEPARTMENT	DATE
NAME		8-16-12
ADDRESS		
CITY, STATE, ZIP		
SOLD BY		
CASH	C.O.D.	SPARGE
ON ACCT.	MOSE. RETD.	PAID OUT

QUANTITY	DESCRIPTION	PRICE	AMOUNT
1	Install septic system		
2	(10 acre rule) &		
3	Do Real Estate		
4	INSPECTION		
5			
6			
7			
8			
9			
10			
11			
12			
13			
14			
15			
16			
17			
18			

Price \$4,000.00

TAX 270.00

Total \$4,270.00

RECEIVED BY:

A-5095  
T-16350/16350

KEEP THIS SLIP FOR REFERENCE

01-11

EMERY DIRT  
AND SEPTIC SERVICE  
(800) 707-2457

MIKE  
787-2457

TOM  
241-8910

DANIEL  
543-0142

INSPECTION CERTIFICATE FOR AN EXISTING ON-SITE SEWAGE DISPOSAL SYSTEM

PROPERTY LOCATION: 2821 FM 1958 FLOYDADA, TX

THE ABOVE SEPTIC SYSTEM WAS INSPECTED TODAY AND THE HISTORY OF THE SYSTEM WAS REVIEWED.  
THE FOLLOWING IS A SUMMARY OF THE FINDINGS:

DATE OF INSTALLATION: 8-16-12  
THE SEPTIC TANK IS CONSTRUCTED OF POLYETHYLENE AND HAS A LIQUID HOLDING  
CAPACITY OF 750 GALLONS.


THE ABSORPTION FIELD CONTAINS 960 SQUARE FEET.  
MAXIMUM RECOMMENDED WASTEWATER LOAD IS 240 GALLONS PER DAY.  
WATER CONSERVATION SHOULD BE PRACTICED WITH THIS SYSTEM AS WITH ALL SEPTIC SYSTEMS.

THE SYSTEM (IS) (IS NOT) CREATING A HEALTH NUISANCE AT THIS TIME.

COMMENTS:

SKETCH OF SYSTEM:

↑  
N

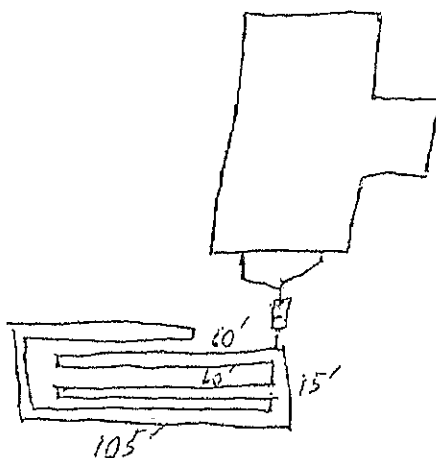

⊗ WELL > 100'

INSPECTOR: TEZ 050028769 DATE: 8-16-12

NOTE: IN MOST INSTANCES THIS INSPECTION PRIMARILY CONSISTS OF A PHYSICAL EXAMINATION OF THE SURFACE AREA AT THE SITE AND VERIFICATION OF TANK MATERIAL COMPOSITION. ANY DEFECT REVEALED BY THE INSPECTION WILL PROBABLY BE THE SURFACE DISCHARGE OF SEPTIC SYSTEM EFFLUENT. IT WILL PROBABLY NOT REVEAL DEFECTS MANIFESTED WITHIN THE HOUSE. THIS INSPECTION CONSTITUTES A DESCRIPTION OF OBSERVABLE SITE CONDITIONS AND SHOULD NOT BE CONSTRUED AS AN OVERALL ASSESSMENT OF THE LONG TERM FUNCTIONAL CAPABILITY OF THE SYSTEM.